

# TOWN OF NEWBURGH PLANNING BOARD TECHNICAL REVIEW COMMENTS

PROJECT NAME:CURALEAF NEWBURGHPROJECT NO.:2021-34PROJECT LOCATION:SECTION 8, BLOCK 5, LOT 15REVIEW DATE:13 OCTOBER 2023MEETING DATE:19 OCTOBER 2023PROJECT REPRESENTATIVE:VINCENT J. DOCE ASSOCIATES/DARREN DOCE

- 1. The applicants are seeking approval for a cannabis dispensary. Zoning Code Section 185-49 Cannabis Related Uses, adopted by the Planning Board as Local Law #1 of 2023 identifies the parameters under which the Planning Board reviews cannabis related uses.
- 2. Zoning Code Section 185-48.9B identifies the cannabis retail dispensary as a Special Use in the B Zone. Special Use Permits require a Public Hearing.
- 3. The application identifies that no external changes to the previously approved site plan dated 28 May 2022 are proposed.
- 4. Zoning Code Section 185-48.9C identifies five conditions the Planning Board should review including:
  - 1) Provisions of sufficient lighting during and after hours of operation.
  - 2) Provision of adequate facilities and personnel for disposal of trash and other debris.
  - 3) Provision for continuing maintenance of the exterior of the building and grounds including landscaping, signs and policing of liter.
  - 4) Sales, product and paraphernalia items related to the preparation of consumption of the product shall not be visible off-site or from a public right-of-way.
  - 5) Outdoor use of sound reproduction devices including but not limited to loud speakers and amplifiers on the premises shall be prohibited

The applicant's representative have provided a Narrative Response addressing each of the above items.

- 5. Zoning Code Section 185-48.9D requires this facility have a valid license issued by the State of New York in order to be considered a Permitted Use. Applicant should provide a copy of the valid license. Expiration or revocation of the license shall be deemed to automatically to terminate the Special Use Permit or other Planning Board Approvals.
- 6. The project is most likely considered a Type II Action as no construction is proposed. The commercial building is less than 4,000 sq. ft.

#### **NEW YORK OFFICE**

33 Airport Center Drive, Suite 202, New Windsor, NY 12553 845-567-3100 | F: 845-567-3232 | mheny@mhepc.com

#### **PENNSYLVANIA OFFICE**

7. No dumpster and or dumpster enclosure are depicted on the plan sheet.

Respectfully submitted,

# MHE Engineering, D.P.C.

Patient & Alenes

Patrick J. Hines Principal

PJH/kbw



Town of Newburgh Planning Board 21 Hudson Valley Professional Plaza Newburgh, New York 12550 Attn: John Ewasutyn, Chairman

Re: Project #2319 – Application for a Special Ferning, New York Dispensary at 8 North Plank Road, Newburgh, New York MHE Engineering, D.P.C. Re: Project #2319 – Application for a Special Permit Appliqation for a Cannabis Retail

Dear Mr. Ewasutyn,

Enclosed in this special use permit application packet for a cannabis retail dispensary are twelve (12) sets of the location's approved site plan, the short Environmental Assessment Form, and narrative responses to the additional requirements for cannabis retail dispensaries as required under §185-48.9(C) of the Town of Newburgh, NY Zoning Bylaws.

The site is a 0.45+/- acre parcel located on the northerly side of North Plank Road (NYS Route 32) between the Alexis Diner and Burger King. The parcel contains an existing medical marijuana dispensary. No external changes to the location are being proposed as part of this application. Pursuant to §185-48.9(B) of the Town's zoning bylaws, special use permits are required to operate cannabis retail dispensaries in the Town of Newburgh; the proposed location is seeking to receive a special use permit to do so.

The parcel is located in the B (business) zone. The existing building does not conform to the required front yard setback. This existing non-conformity will not be increased. The proposed use will not change existing impervious areas. Therefore, the lot surface coverage will not increase.

The site has access to North Plank Road through two existing drives. These drives will remain. The existing building is connected to municipal sewer and water. Stormwater runoff flows toward North Plank Road (NYS Rte. 32) and is collected by the stormwater drainage system located within the NYS right-of-way. There will not be an increase in impervious area or stormwater runoff.

Please feel free to reach out with any questions or requests for additional information.

kindly

Kate Crowther

Senior Vice-President, Tenax Strategies 617-459-6671 kate@tenaxstrategies.com

DRIVEN | DEDICATED | DETERMINED

# **TOWN OF NEWBURGH** APPLICATION FOR SUBDIVISION/SITE PLAN REVIEW

# **RETURN TO: Town of Newburgh Planning Board** 308 Gardnertown Road Newburgh, New York 12550

### DATE RECEIVED:

### TOWN FILE NO:\_\_\_

# (Application fee returnable with this application)

1. Title of Subdivision/Site Plan (Project name): Special Permit for Curaleaf of Newburgh

### 2. Owner of Lands to be reviewed:

Name	Magdalini Zacharia	
Address	140 Putt Lane	 
	Kingston, NY 12401	 
Phone	(845) 206-7193	

### 3. A

Name	SAME		
Address			
Representativ	e		 
Phone			
Fax		 	 ···
Email			

### 4. Subdivision/Site Plan prepared by:

Name Address Darren C. Doce - Vincent J. Doce Associates 41 Mead Allev Montgomery, NY 12549

Phone/Fax

(845) 561-1170, ddoce@hotmail.com

5. Location of lands to be reviewed: 8 North Plank Road

6.	Zone B Acreage 0.45+/-	Fire District Cronomer Valley School District Newburgh	
7.	Tax Map: Section 80	Block 5 Lot 19	

<b>Project Description</b>	oject Description and Purpose of Review:				
Number of exis	sting lots	Number of proposed lots			
Lot line change	e e				
Site plan review	W				
Clearing and g	rading				
Other	Special Permit				
	Number of exis Lot line change Site plan review Clearing and g	Number of existing lots         Lot line change         Site plan review         Clearing and grading			

PROVIDE A WRITTEN SINGLE PAGE DESCRIPTION OR NARRATIVE OF THE PROJECT

- 9. Easements or other restrictions on property: (Describe generally)
- 10. The undersigned hereby requests approval by the Planning Board of the above identified application and scheduling for an appearance on an agenda:

Signature			Zacharicy	Title	Duner	· · · · · · · · · · · · · · · · · · ·
Date:	92	6	9093			

<u>NOTE:</u> If property abuts and has its access to a County or State Highway or road, the following information must be placed on the subdivision map or site plan: entrance location, entrance profile, sizing of pipe (minimum length of pipe to be 24 feet).

The applicant will also be required to submit an additional set of plans, narrative letter and EAF if referral to the Orange County Planning Department is required under General Municipal Law Section 239.

# Short Environmental Assessment Form Part 1 - Project Information

### **Instructions for Completing**

Part 1 - Project Information. The applicant or project sponsor is responsible for the completion of Part 1. Responses become part of the application for approval or funding, are subject to public review, and may be subject to further verification. Complete Part 1 based on information currently available. If additional research or investigation would be needed to fully respond to any item, please answer as thoroughly as possible based on current information.

Complete all items in Part 1. You may also provide any additional information which you believe will be needed by or useful to the lead agency; attach additional pages as necessary to supplement any item.

Part 1 - Project and Sponsor Information		
Name of Action or Project:		
Speak Permit For Curaleaf of New	Nourah	
Project Location (describe, and attach a location map):		
8 North Plank Road, New burgh	ANY ATTINAT COL	1
Brief Description of Proposed Action:	1, 101, OTWICK CON	uny
The applicant is proposing to add an adult use retail cannabis o	dispensary use to the existing med	ical
cannabis dispensary which is already operational at this site. The existing building, which will remain untouched, is connected to	here will be no changes to the site	
		•
Name of Applicant or Sponsor:	Telephone: (845). 206 - 7193	
Magdalini Zacharia	E-Mail: 1201@ VEV120N N	et
Address:	<u> </u>	
140 PUTE M.		
City/PO:	State: Zip Code:	
KINGSTON	NY 1240	
1. Does the proposed action only involve the legislative adoption of a plan, le	ocal law, ordinance, NO	YES
administrative rule, or regulation? If Yes, attach a narrative description of the intent of the proposed action and	the environmental recourses that	
may be affected in the municipality and proceed to Part 2. If no, continue to	question 2.	
2. Does the proposed action require a permit, approval or funding from any		YES
If Yes, list agency(s) name and permit or approval: TOWN OF NUW DU	Ign Planning Board	
	. <u>U5+/-</u> acres	1
b. Total acreage to be physically disturbed? c. Total acreage (project site and any contiguous properties) owned	0 acres	;
or controlled by the applicant or project sponsor?	82+1- acres	
4. Check all land uses that occur on, adjoining and near the proposed action.		
	ercial Residential (suburban)	
☐Forest ☐Agriculture ☐Aquatic ☐Other ( ☐Parkland	specify):	

5. Is the proposed action, N	0 V	ES	N/A
a. A permitted use under the zoning regulations?	ŤŔ	-	
b. Consistent with the adopted comprehensive plan?	╡┟╞	オ	屵
6. Is the proposed action consistent with the predominant character of the existing built or natural landscape?		5 7	YES
7. Is the site of the proposed action located in, or does it adjoin, a state listed Critical Environmental Area? If Yes, identify:	- [.	ן ק א	YES
		2	
8. a. Will the proposed action result in a substantial increase in traffic above present levels?	NC		YES
b. Are public transportation service(s) available at or near the site of the proposed action?	H.	+	H
c. Are any pedestrian accommodations or bicycle routes available on or near site of the proposed action?		1	Π
9. Does the proposed action meet or exceed the state energy code requirements? If the proposed action will exceed requirements, describe design features and technologies:	NO		YES
	-		
10. Will the proposed action connect to an existing public/private water supply?	NO	4	YES
If No, describe method for providing potable water:		]	$\square$
11. Will the proposed action connect to existing wastewater utilities?	NO		YES
If No, describe method for providing wastewater treatment:		]	$\overline{\mathbf{N}}$
12. a. Does the site contain a structure that is listed on either the State or National Register of Historic Places?	NO		YES
b. Is the proposed action located in an archeological sensitive area?			
13. a. Does any portion of the site of the proposed action, or lands adjoining the proposed action, contain wetlands or other waterbodies regulated by a federal, state or local agency?	NO		YES V
b. Would the proposed action physically alter, or encroach into, any existing wetland or waterbody? If Yes, identify the wetland or waterbody and extent of alterations in square feet or acres;	$\overline{\mathbb{V}}$		
14. Identify the typical habitat types that occur on, or are likely to be found on the project site. Check all that         □ Shoreline       □ Forest         □ Wetland       □ Urban	it apply:	1_	
15. Does the site of the proposed action contain any species of animal, or associated habitats, listed	NO		YES
by the State or Federal government as threatened or endangered? Raid Eagle			ন
16. Is the project site located in the 100 year flood plain?	NO		YES
17. Will the proposed action create storm water discharge, either from point or non-point sources?	NO	+	YES
a. Will storm water discharges flow to adjacent properties?		Ē	
b. Will storm water discharges be directed to established conveyance systems (runoff and storm drains)? If Yes, briefly describe:			

18. Does the proposed action include construction or other activities that result in the impoundment of	NO	YES
water or other liquids (e.g. retention pond, waste lagoon, dam)? If Yes, explain purpose and size:		1
	1 TT	
19. Has the site of the proposed action or an adjoining property been the location of an active or closed solid waste management facility?	NO	YES
If Yes, describe:	$\square$	
20. Has the site of the proposed estion on a division of the site		-
20. Has the site of the proposed action or an adjoining property been the subject of remediation (ongoing or completed) for hazardous waste?	NO	YES
If Yes, describe:		
I AFFIRM THAT THE INFORMATION PROVIDED ABOVE IS TRUE AND ACCURATE TO THE H	EST O	FMY
KNOWLEDGE Applicant/sponsor name: Magdalini Zacharia Date: 9/26 Signature: Magda Zacharia	208	13
Signature: Magda Zachavia		· -



### Newburgh Special Permit Narrative Responses

### Odors

The proposed retail dispensary shall follow all requirements of Article 13-E of the Public Health Law (the Clean Indoor Air Act). Furthermore, the proposed location will not constitute a nuisance by producing odor beyond that emitted by a typical non-cannabis retail establishment. All cannabis products sold at the retail dispensary will arrive prepackaged and no cultivation or product manufacturing will take place at the location. As such, there will be limited odor produced by the establishment.

#### **Operational Schedule**

8am-9pm Mon-Sat 8am-7pm Sun

#### The Public Welfare

Both public safety and the public welfare will be provided for at the proposed establishment. The location will have locked doors with keycard access, security cameras covering the interior and exterior of the building, emergency/panic alarms to rapidly contact law enforcement in the event of an emergency, and interior restricted access areas not accessible to the public. During non-operational hours, all interior and exterior doors will be secured and the alarm system will be armed. Cannabis products will be stored during off-hours in the GSA approved Class 5 security vault. In order to further advance the public welfare, consumer education materials on the proper use and effects of cannabis will be available for both adult-use and medical visitors.

### Lighting

The lighting for the proposed retail dispensary, as detailed on the included site plan, includes five perimeter lights placed at the corners of the lot. These perimeter lights are high-powered DCM B1AN1 pole-mounted area lights. Additionally, the exterior of the building has six WAC Lighting 5" LED up-down wall sconces to illuminate the entrance and exit of the building. These LED lights have a wattage of 27 per bulb (54 total) and provide substantial area lighting to the front face of the building. Additionally, the parking spaces directly in front of the building are illuminated by seven bollard lighting fixtures. Finally, the underside of the roof overhang that rings the building also has lighting fixtures with standard outdoor bulbs inset. These inset fixtures provide substantial area lighting around the perimeter of the building, illuminating the space for security footage, visitors, and employees.

#### Waste Disposal

The applicant maintains exclusive use and maintenance of existing dumpsters located on-site for all non-cannabis waste.

Upon identifying solid cannabis waste in need of disposal, said cannabis waste will be rendered unusable prior to disposal. This may include grinding, shredding, and/or mixing the cannabis waste with other materials such that it is unusable. Once this process has been completed, the waste will be weighed and recorded in the cannabis waste logbook. This entry may include such

#### DRIVEN | DEDICATED | DETERMINED



details as date and time of entry, employee disposing of the waste, weight of waste, and type of product being disposed. Once the waste has been recorded, the waste will be placed in a locked waste container. The cannabis waste disposal—along with the standard waste disposal—will be contracted out to a third-party solid waste disposal company. They will handle pickup of waste at the location and complete the disposal process.

#### Exterior Maintenance


The location will ensure that adequate resources and effort is provisioned for the continued maintenance of the exterior of the building and the grounds. The applicant has contracted services, and will maintain said service contracts, for the purpose of maintenance and landscaping to ensure the continued maintenance and upkeep of the exterior of the location.


### Product Visibility

The proposed retail dispensary shall not have any cannabis sales product or paraphernalia items related to the preparation or consumption of product be visible off-site or from a public right-of-way. Furthermore, the dispensary shall not display any packaging, labeling, or other merchandise that could reasonably be mistaken for a cannabis product in a storefront window or other similar location that makes that item easily visible to individuals utilizing the public throughfare on which the dispensary is located.

### **Outside Sound**

There will not be any outdoors sound reproduction devices (speakers) at the proposed location. As a result, the establishment will not produce any noise beyond that of a typical non-cannabis retail establishment.

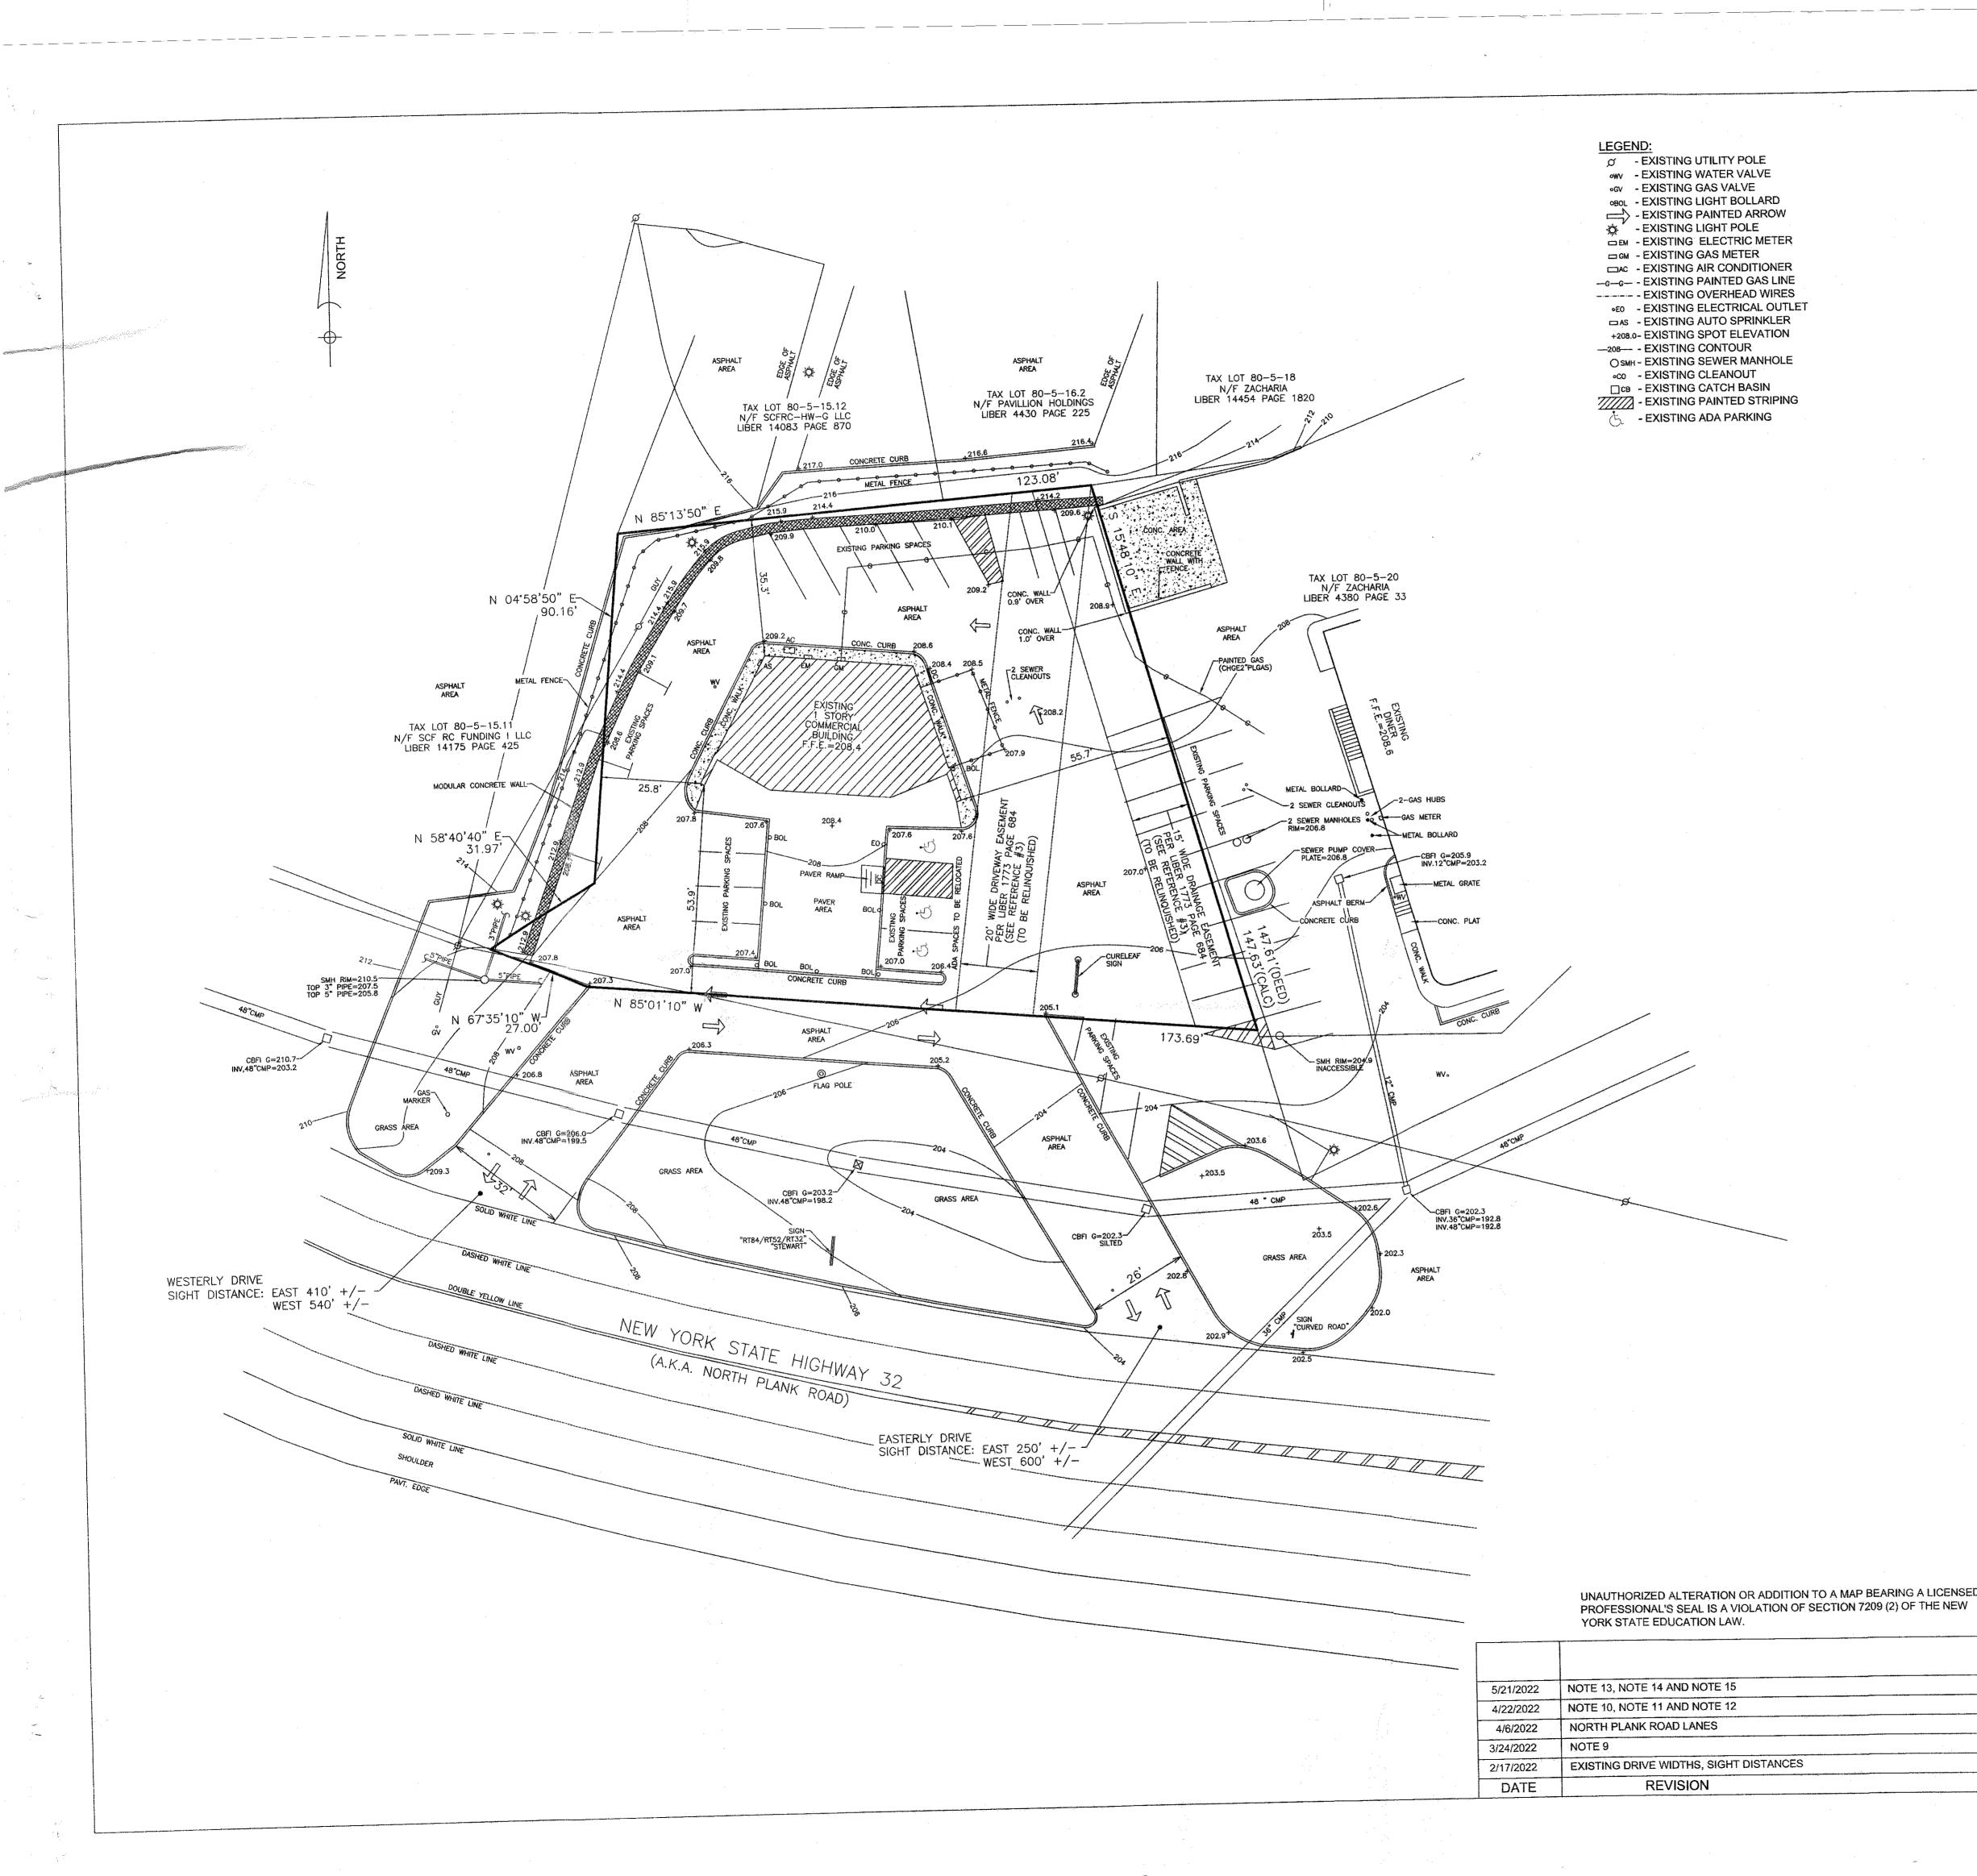

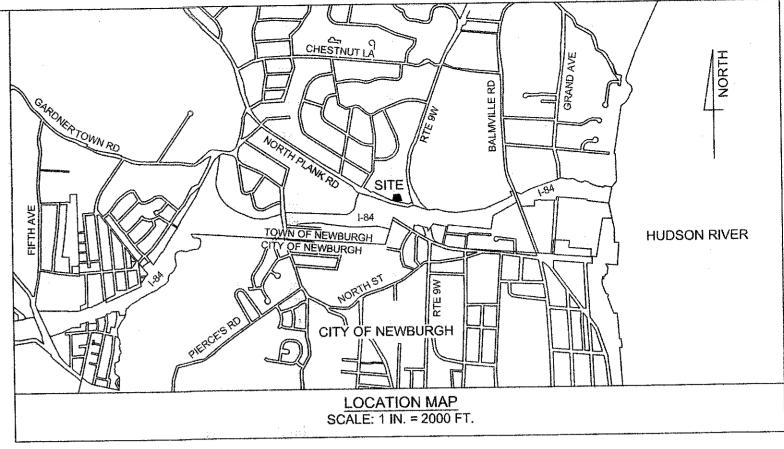

ZONE - B (BUSINESS) USE - RETAIL/OFFICE

\_\_\_\_\_

MINIMUM REQUIRED REGULATION LOT AREA LOT WIDTH LOT DEPTH FRONT YARD REAR YARD ONE SIDE YARD BOTH SIDE YARDS MAXIMUM PERMITTED

LOT BUILDING COVERAGE LOT SURFACE COVERAGE BUILDING HEIGHT

NOTES:

1. TAX MAP DESIGNATION: SECTION 80 BLOCK 5 LOT 19

15,000 SQ. FT.

100 FT.

125 FT.

60 FT.

30 FT.

15 FT.

30 FT.

60 %

85 %

35 FT.

2. PARCEL AREA = 0.45 ACRES +/-


- 3. ZONING DISTRICT B (BUSINESS) 4. OWNER AND APPLICANT: MAGDALINI ZACHARIA
  - 140 PUTT LANE
- KINGSTON, NY 12401 5. BOUNDARY AND TOPOGRAPHIC (HORIZONTAL AND VERTICAL) SURVEY INFORMATION AS PER A MAP ENTITLED "BOUNDARY & TOPOGRAPHIC SURVEY, 8 NORTH PLANK ROAD LOCATED AT TAX LOT 80-5-19 TOWN OF NEWBURGH, COUNTY OF ORANGE, NEW YORK " PREPARED BY HERITAGE LAND SURVEYING, PC (DARREN J. STRIDIRON, PLS - NYS LICENSE NO. 050487), DATED NOVEMBER 17, 2021.
- 6. THE LOCATIONS (HORIZONTAL AND VERTICAL) AND SIZES OF THE UNDERGROUND UTILITIES SHOWN SHALL NOT BE RELIED ON AS BEING EXACT OR COMPLETE. THE CONTRACTOR MUST DETERMINE THE EXACT LOCATION, ELEVATION AND SIZE OF ANY EXISTING UNDERGROUND UTILITY. BEFORE BEGINNING CONSTRUCTION, THE CONTRACTOR MUST PERFORM EXPLORATORY EXCAVATIONS TO LOCATE THE EXISTING UNDERGROUND UTILITIES SUFFICIENTLY AHEAD OF CONSTRUCTION TO PERMIT MAKING REVISIONS AS NEEDED.
- 7. ANY EXISTING STRUCTURE, CURB, PAVED AREA, LANDSCAPED AREA, ETC. DISTURBED DURING CON-STRUCTION SHALL BE RESTORED TO ITS ORIGINAL CONDITION.
- 8. IT IS THE DEVELOPER'S OR CONTRACTOR'S RESPONSIBILITY TO OBTAIN ANY NECESSARY PERMITS REQUIRED FROM FEDERAL, STATE OR LOCAL AUTHORITIES.
- 9. PRIOR TO PERFORMING ANY WORK WITHIN THE NEW YORK STATE DEPARTMENT OF TRANSPORTATION (NYSDOT) RIGHT-OF-WAY, A HIGHWAY WORK PERMIT MUST BE OBTAINED FROM THE NYSDOT. ALL WORK AND MATERIALS USED WITHIN THE NYSDOT RIGHT-OF WAY MUST CONFORM WITH THE CURRENT NYSDOT STANDARDS AND SPECIFICATIONS.
- 10. PRIOR TO THE PLANS BEING SIGNED AND SEALED BY THE TOWN OF NEWBURGH PLANNING BOARD CHAIRMAN, THE EXISTING ONSITE STORAGE POD SHALL BE REMOVED.
- 11. PRIOR TO THE ISSUANCE OF ANY BUILDING PERMITS FOR THE PROJECT, A HIGHWAY WORK PERMIT SHALL BE OBTAINED FROM THE NYSDOT. 12. WORK ZONE TRAFFIC CONTROL SHALL BE PROVIDED AS PER THE NYSDOT 619 STANDARD SHEETS,
- THE FEDERAL HIGHWAY ADMINISTRATION MANUAL ON UNIFORM TRAFFIC CONTROL DEVICES (MUTCD) AND THE NYS SUPPLEMENT TO THE MUTCD. 13. DURING CONSTRUCTION, PUBLIC ROADWAYS SHALL BE KEPT CLEAN AND FREE OF SEDIMENT AND
- CONSTRUCTION DEBRIS AT ALL TIMES. 14. ALL WORK UNDER NEW YORK STATE DEPARTMENT OF TRANSPORTATION JURISDICTION SHALL BE COMPLETED IN CONFORMANCE WITH NYSDOT 608-03 STANDARD SHEETS AND THE APPROVED DETAILS
- SHOWN ON THESE PLANS. 15. THE NYSDOT HIGHWAY WORK PERMIT AND NYSDOT STAMPED APPROVED PLANS SHALL BE PRESENT AT THE CONSTRUCTION SITE LOCATION AT ALL TIMES THROUGHOUT CONSTRUCTION.
  - SITE PLAN APPROVED Planning Board, Town of Newburgh Orange County, New York In K. Guant Chairman


in the Ball MHE Engineering, D.P.C


5/28/2022 CALL BEFORE YOU DIG DIG SAFELY NEW YORK MUST BE CONTACTED (DIAL 811 OR 1-800-962-7962) AT LEAST TWO FULL WORKING DAYS PRIOR TO ANY EXCAVATION, DRILLING OR BLASTING TO HAVE ANY EXISTING UNDERGROUND UTILITIES LOCATED AND MARKED, NON-MEMBER UTILITIES MUST BE CONTACTED SEPARATELY,

SHEET 1 OF 3 IS INVALID UNLESS ACCOMPANIED BY SHEET 2 OF 3 AND SHEET 3 OF 3.

	AMENDED SITE PLAN - EXISTING CONDITIONS PLAN FOR CURALEAF NEWBURGH - BUILDING ADDITION 8 NORTH PLANK ROAD, TOWN OF NEWBURGH
D	ORANGE COUNTY, NEW YORK
	DATE: NOVEMBER 18, 2021 SCALE: 1 IN. = 20 FT.
	PREPARED BY: VINCENT J. DOCE ASSOCIATES SURVEYORS - ENGINEERS - PLANNERS 41 MEAD ALLEY, MONTGOMERY, NY 12549 TEL. 845 561-1170 EMAIL DDOCE12@HOTMAIL.COM SHEET 1 OF 3 Danen WR

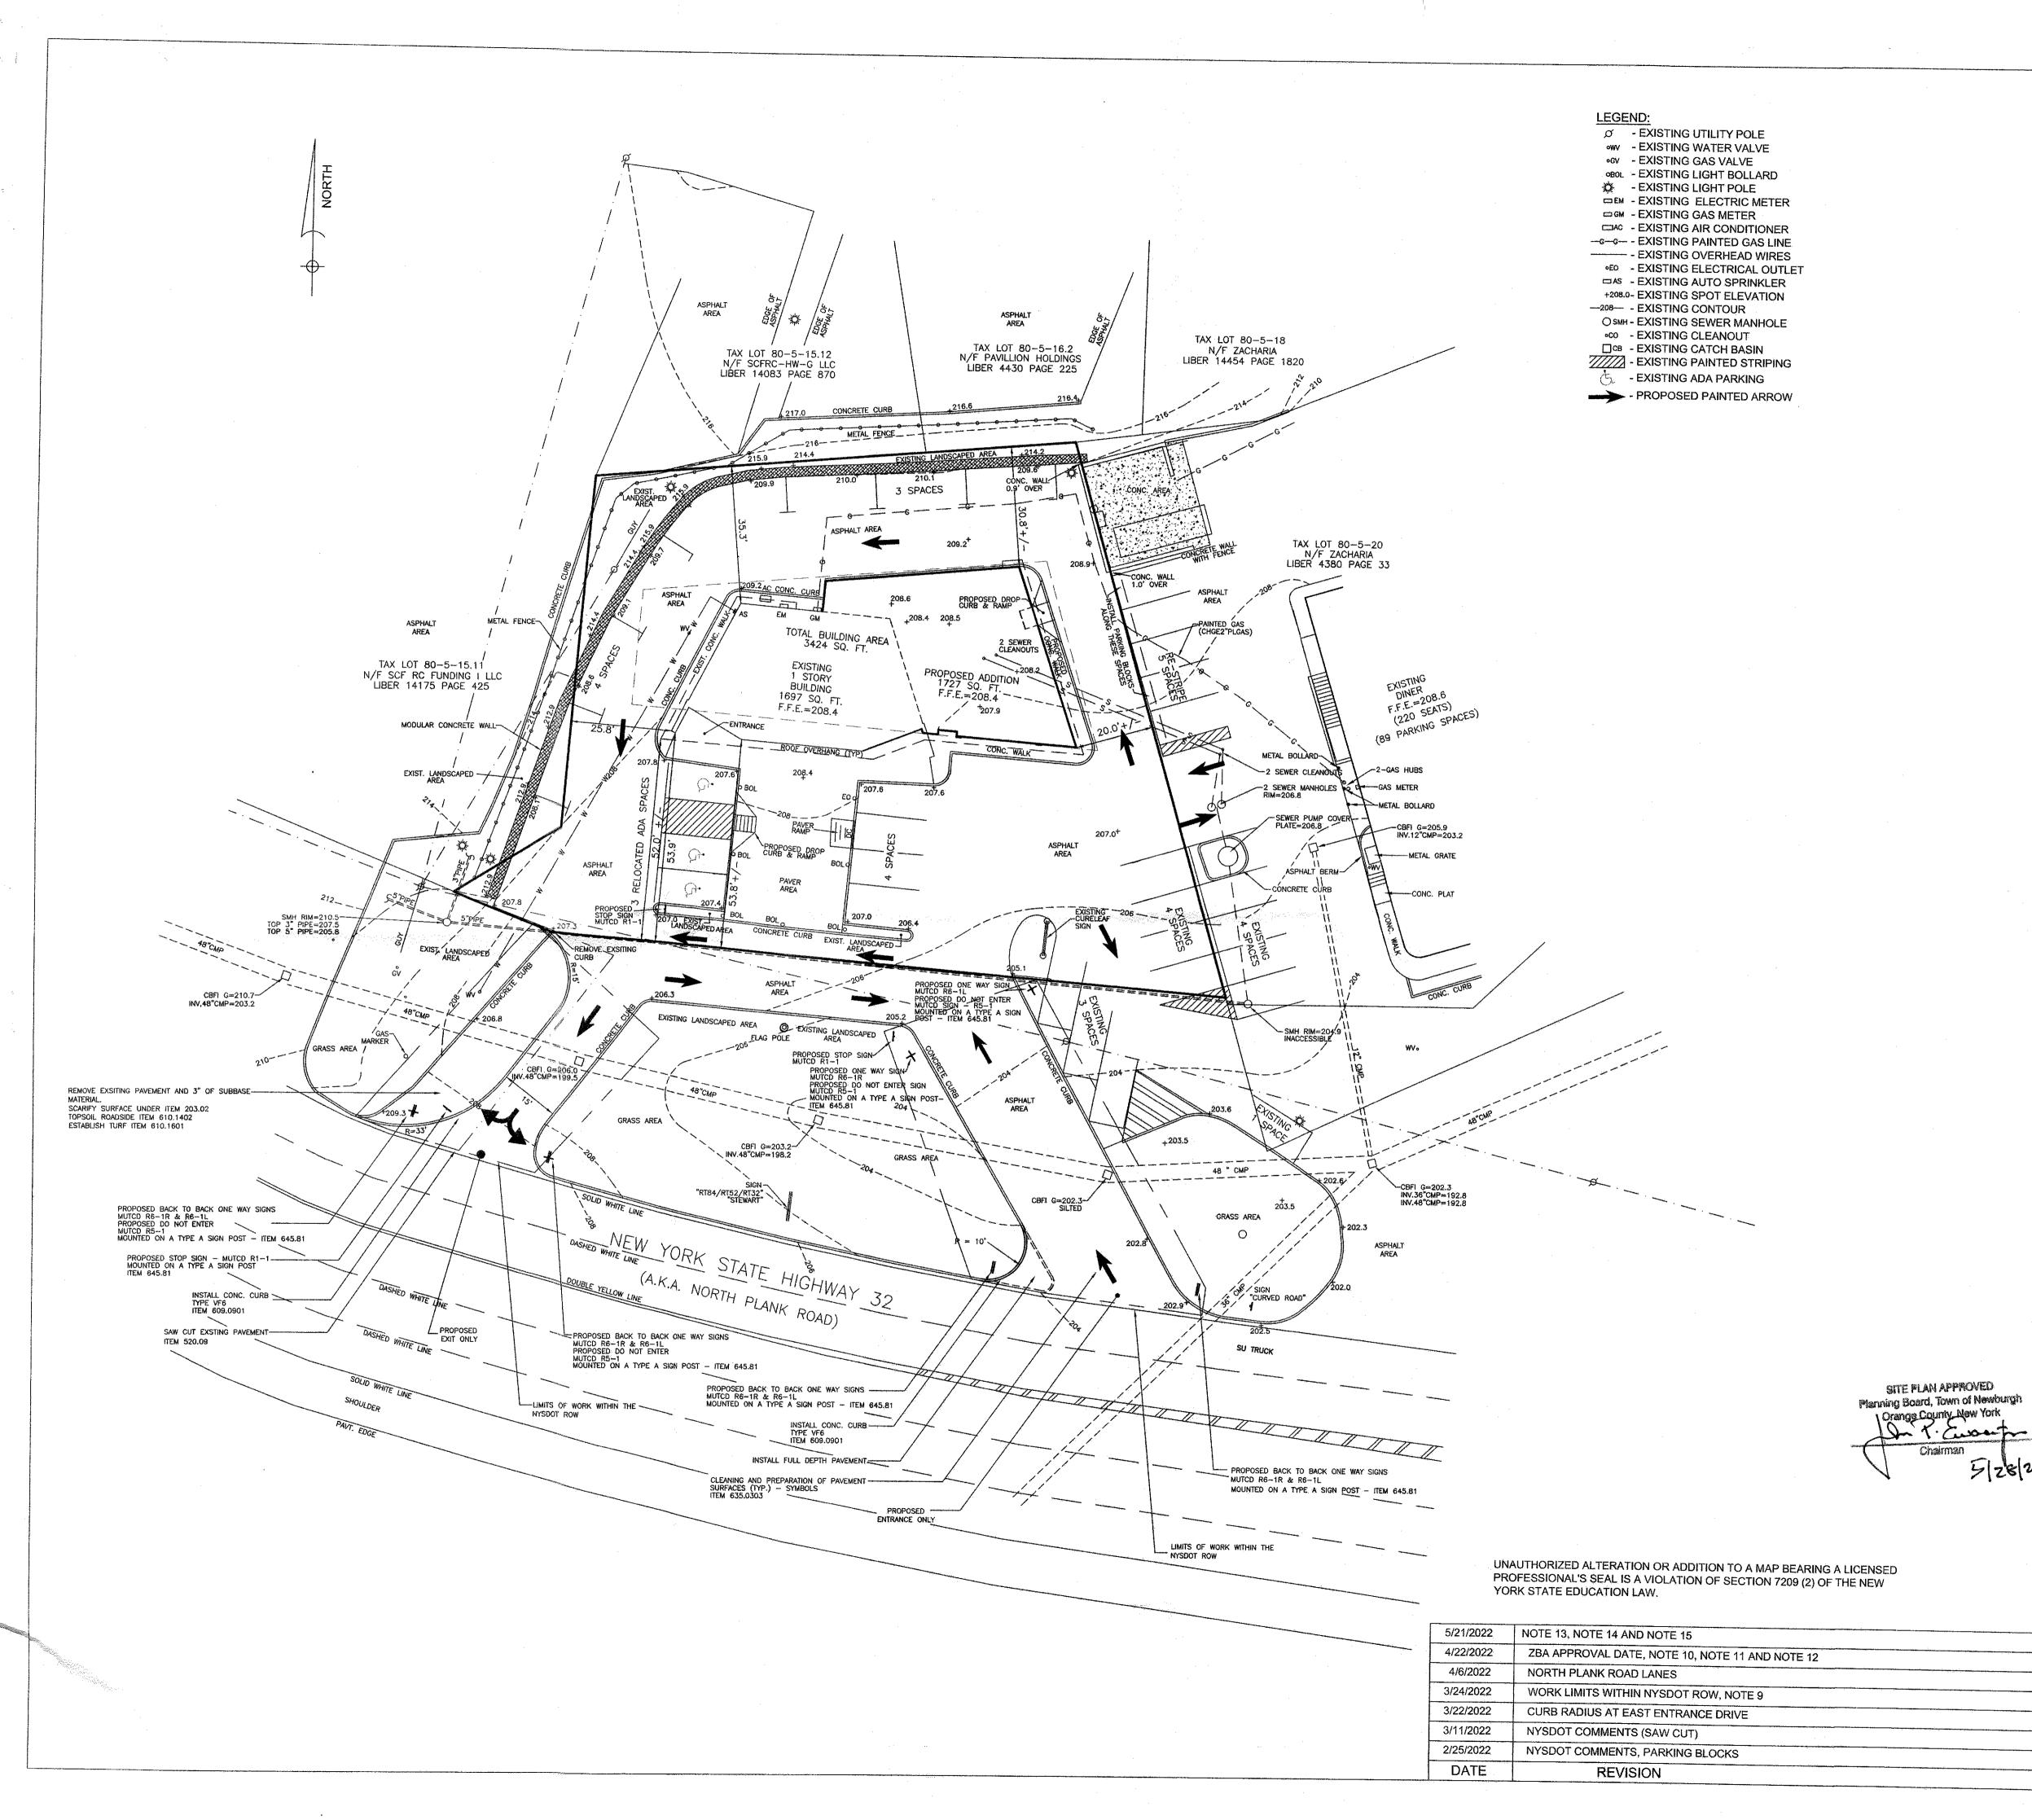


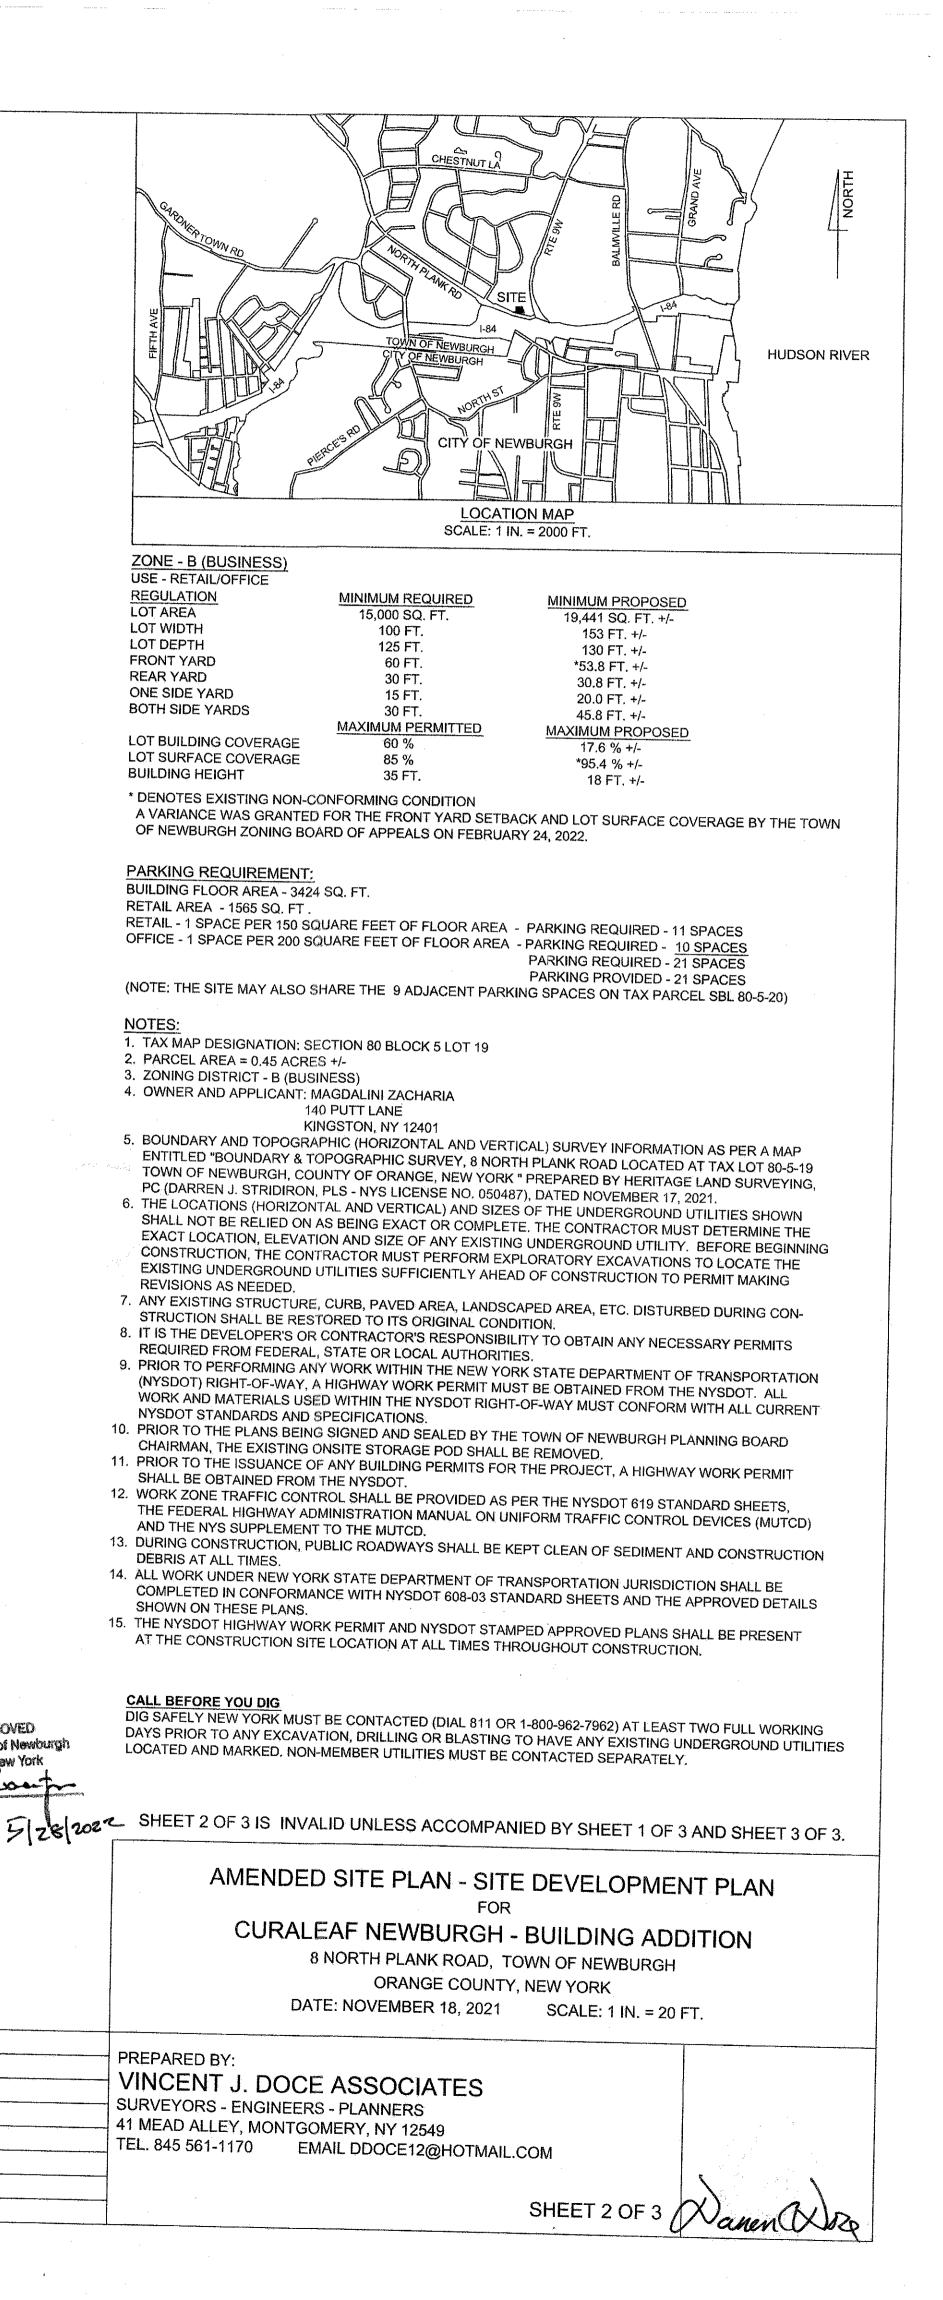

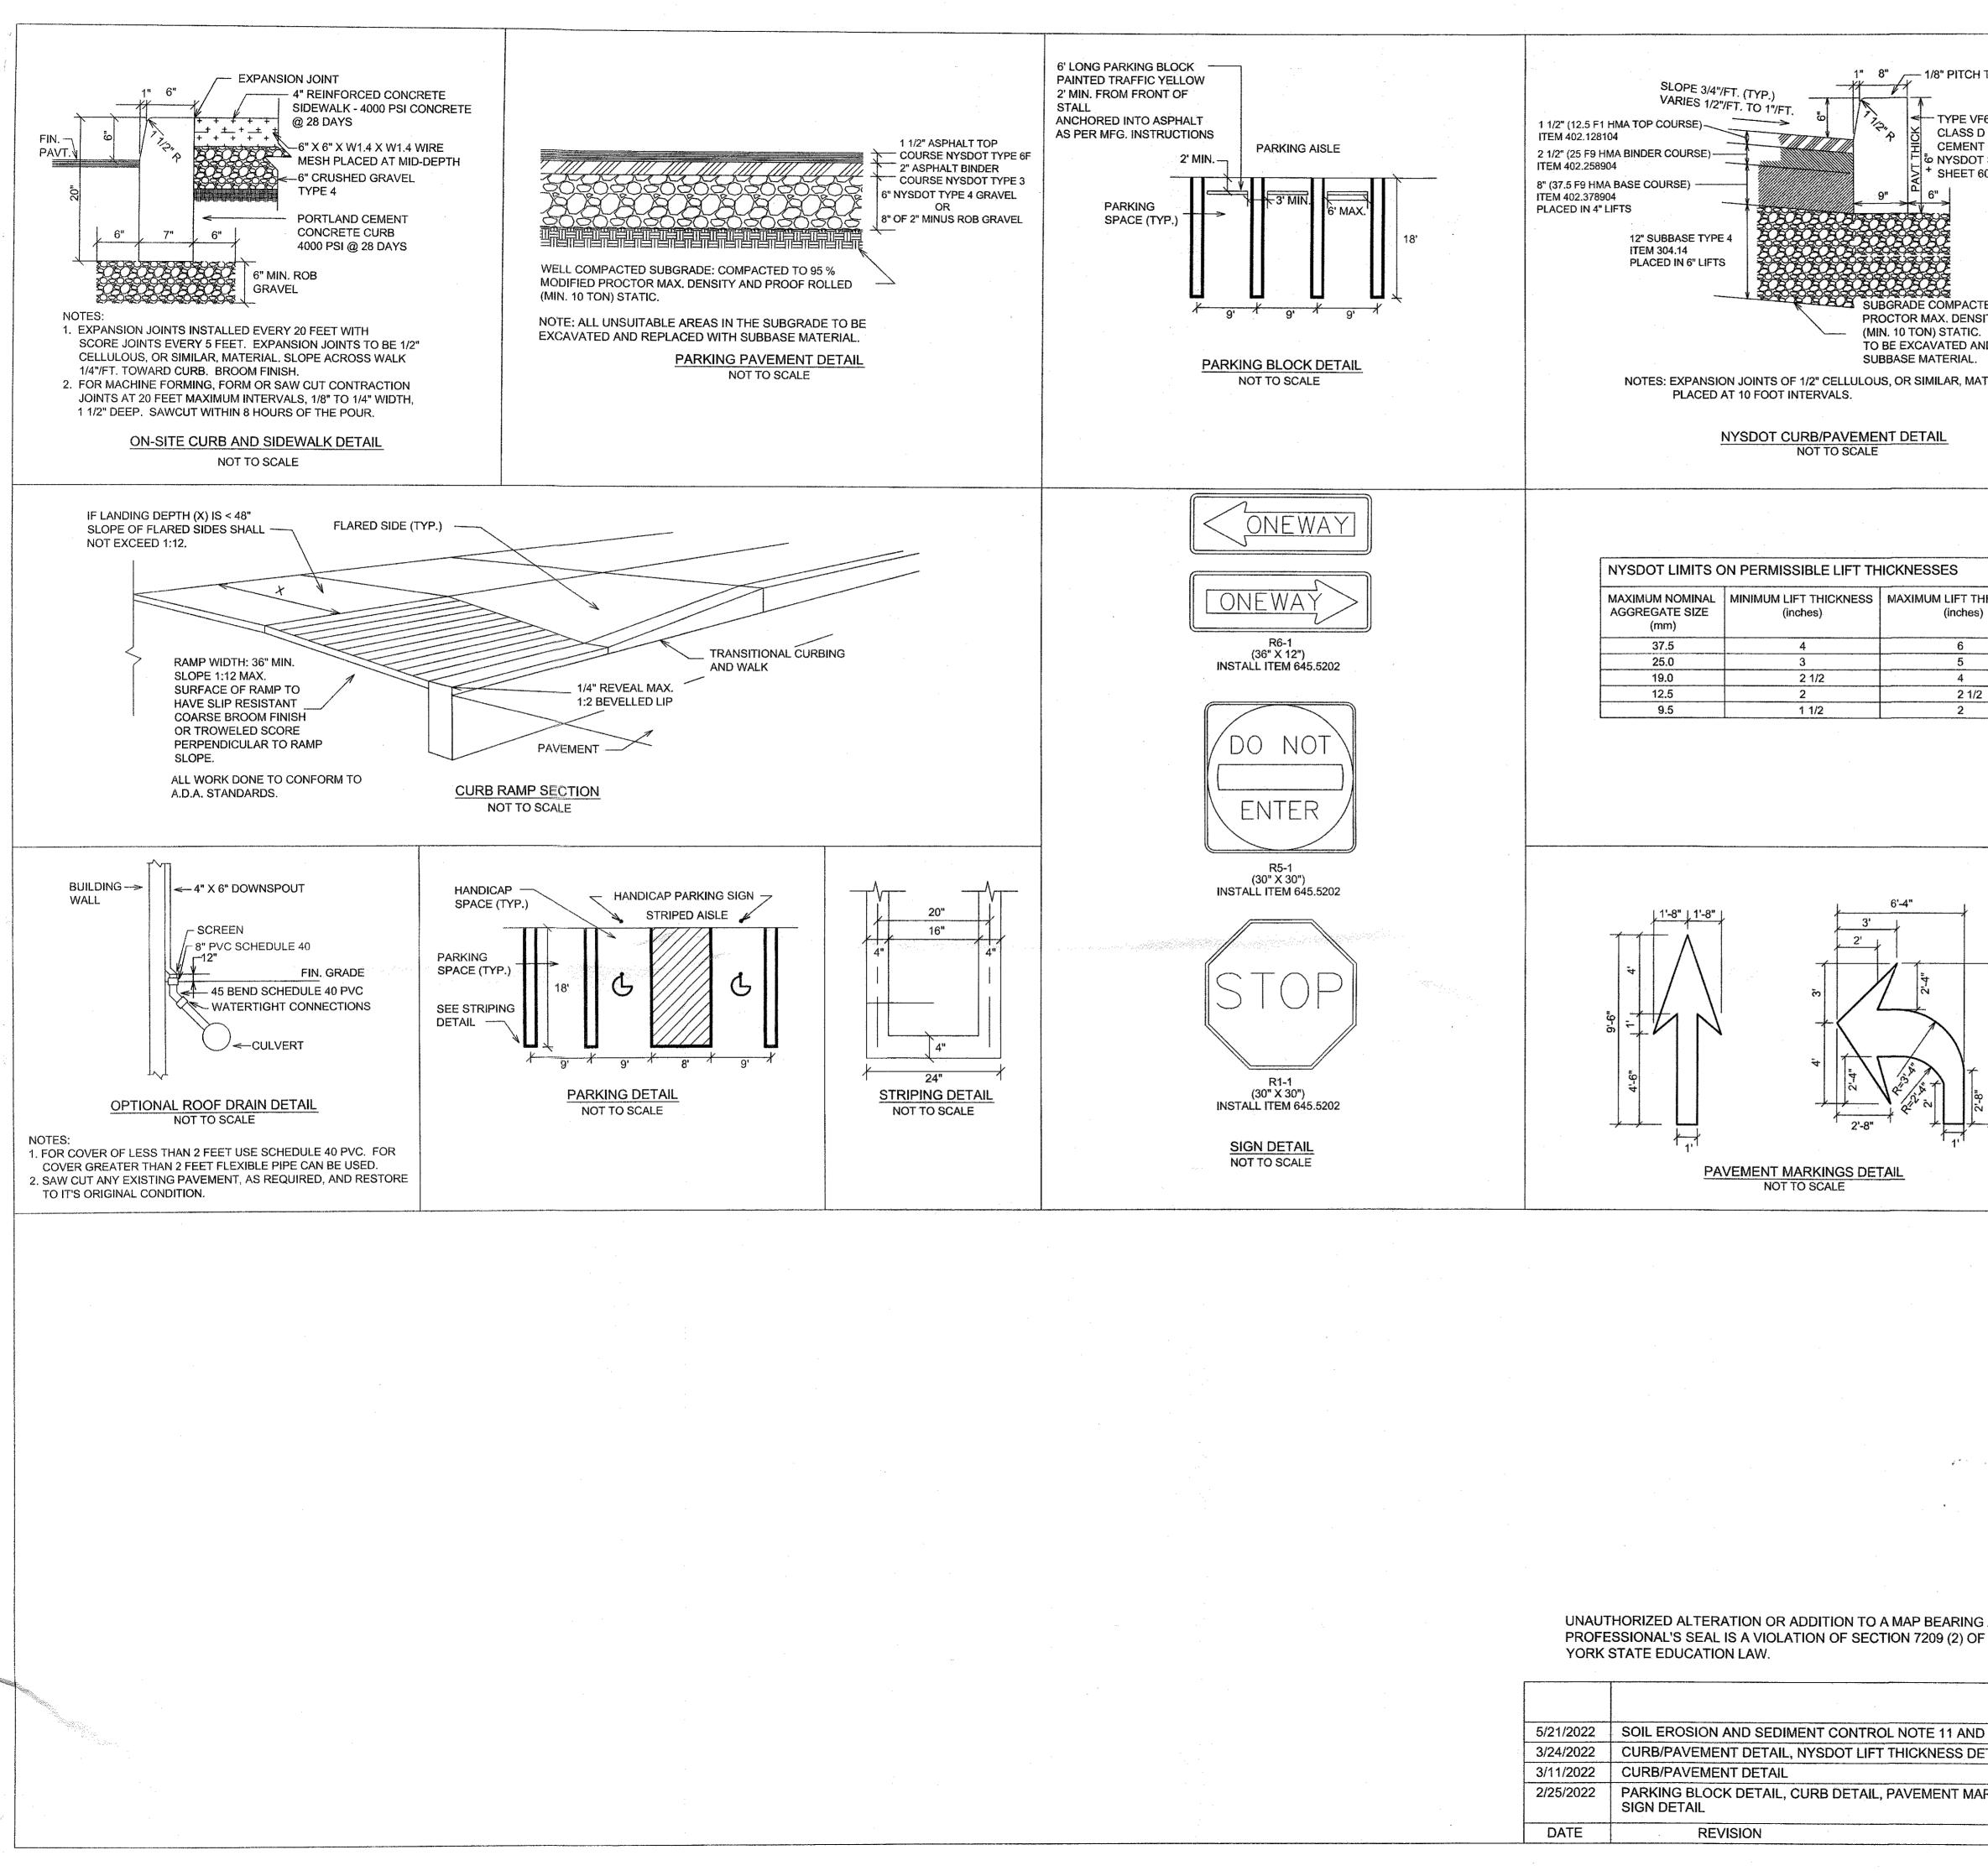

5/21/2022	SOIL EROSION AND SEDIMENT CONTROL NOTE 11 AND
3/24/2022	CURB/PAVEMENT DETAIL, NYSDOT LIFT THICKNESS DET
3/11/2022	CURB/PAVEMENT DETAIL
2/25/2022	PARKING BLOCK DETAIL, CURB DETAIL, PAVEMENT MAR SIGN DETAIL
DATE	REVISION

, .	GENERAL NOTES:
H TO ROADWAY	1. BEFORE BEGINNING CONSTRUCTION THE CONTRACTOR MUST DETERMINE THE EXACT LOCATION, ELEVATION
	AND SIZE OF ANY EXISTING UNDERGROUND UTILITY. THE CONTRACTOR SHOULD PERFORM EXPLORATORY EXCAVATIONS, AS NECESSARY, TO LOCATE EXISTING UNDERGROUND UTILITIES SUFFICIENTLY AHEAD OF
/F6	CONSTRUCTION TO PERMIT MAKING REVISIONS AS NEEDED. THE LOCATIONS (HORIZONTAL AND VERTICAL)
D PORTLAND	SHALL NOT BE RELIED ON AS BEING EXACT OR COMPLETE. 2. ANY EXISTING STRUCTURE, CURB, PAVED AREA, LANDSCAPED AREA, ETC., DISTURBED DURING CONSTRUC-
DT STANDARD	TION SHALL BE RESTORED TO ITS ORIGINAL CONDITION.
	3. IT IS THE DEVELOPER'S OR CONTRACTOR'S RESPONSIBILITY TO OBTAIN ANY NECESSARY PERMITS REQUIRED FROM FEDERAL, STATE OR LOCAL AUTHORITIES.
	<ol> <li>PRIOR TO PERFORMING ANY WORK WITHIN THE NEW YORK STATE DEPARTMENT OF TRANSPORTATION (NYSDOT) RIGHT-OF-WAY, A HIGHWAY WORK PERMIT MUST BE OBTAINED FROM THE NYSDOT. ALL</li> </ol>
	WORK AND MATERIALS USED WITHIN THE NYSDOT RIGHT-OF-WAY MUST CONFORM WITH ALL CURRENT NYSDOT STANDARDS AND SPECIFICATIONS.
	5. WORK ZONE TRAFFIC CONTROL SHALL BE PROVIDED AS PER THE NYSDOT 619 STANDARD SHEETS, THE FEDERAL HIGHWAY ADMINISTRATION MANUAL ON UNIFORM TRAFFIC CONTROL DEVICES (MUTCD)
	AND THE NYS SUPPLEMENT TO THE MUTCD.
CTED TO 95 % MODIFIED	6. ALL WORK UNDER NEW YORK STATE DEPARTMENT OF TRANSPORTATION JURISDICTION SHALL BE COMPLETED IN CONFORMANCE WITH NYSDOT 608-03 STANDARD SHEETS AND THE APPROVED DETAILS
C. UNSTABLE AREAS	SHOWN ON THESE PLANS. 7. THE NYSDOT HIGHWAY WORK PERMIT AND NYSDOT STAMPED APPROVED PLANS SHALL BE PRESENT
a construction of the late of	AT THE CONSTRUCTION SITE LOCATION AT ALL TIMES THROUGHOUT CONSTRUCTION.
ATERIAL	
	SOIL EROSION AND SEDIMENT CONTROL NOTES:
	<ol> <li>ALL WORK TO BE DONE IN ACCORDANCE WITH STANDARDS SET FORTH IN "NEW YORK STATE STANDARDS AND SPECIFICATIONS FOR EROSION AND SEDIMENT CONTROL," LATEST EDITION, PREPARED BY THE USDA</li> </ol>
	SOIL CONSERVATION SERVICE. 2. ONLY THOSE AREAS NECESSARY IN THE DEVELOPMENT OF THE PARCEL SHALL BE DISTURBED. SOIL
	DISTURBANCES SHALL BE LIMITED TO LESS THAN 1 ACRE.
	3. ALL SOIL EROSION AND SEDIMENT CONTROL PRACTICES ARE TO BE INSTALLED PRIOR TO ANY MAJOR SOIL DISTURBANCE, OR IN THEIR PROPER SEQUENCE, AND MAINTAINED UNTIL PERMANENT PROTECTION IS
	ESTABLISHED. 4. DURING CONSTRUCTION, THE CONTRACTOR IS RESPONSIBLE FOR MAINTAINING ALL PERMANENT EROSION
······	AND SEDIMENT CONTROL MEASURES. THE PROPERTY OWNER WILL ASSUME THIS RESPONSIBILITY AFTER CONSTRUCTION IS COMPLETED AND CERTIFICATES OF OCCUPANCY ARE ISSUED.
	5. NO DISTURBED AREA SHALL BE LEFT BARE FOR MORE THAN 14 DAYS UNLESS CONSTRUCTION OR SITE
THICKNESS s)	PREPARATION IS TAKING PLACE. 6. EXISTING CATCHBASINS AND CULVERTS SHALL BE PROTECTED TO PREVENT SEDIMENT FROM ENTERING
~,	THE STRUCTURE. 7. ALL EXCAVATED EARTH AND ACCUMULATED SEDIMENT WHICH WILL NOT BE USED ON-SITE SHALL BE HAULED
	OFF THE SITE AND DISPOSED OF PROPERLY. 8. ANY EROSION AND SEDIMENT CONTROL MEASURE IS TO BE PERIODICALLY INSPECTED, MAINTAINED AND
	REPLACED WHEN IT BECOMES INOPERABLE. 9. ALL WASTE MATERIAL (I.E. CONSTRUCTION DEBRIS AND TRASH) SHALL BE HAULED TO AN APPROVED LAND-
/2	FILL. NO CONSTRUCTION DEBRIS SHALL BE BURIED ON-SITE. ALL LOOSE MATERIALS SHALL BE REGULARLY
	COLLECTED TO PREVENT THE RELEASE OF FLOATABLES DURING STORM EVENTS. 10. ONCE CONSTRUCTION IS COMPLETE AND THE AREA HAS BECOME PERMANENTLY STABILIZED, ANY TEMPOR-
	ARY EROSION AND SEDIMENT CONTROL MEASURE SHALL BE REMOVED AND DISPOSED OF PROPERLY. 11. DURING CONSTRUCTION, PUBLIC ROADWAYS SHALL BE KEPT CLEAN AND FREE OF SEDIMENT AND CONSTRUC-
	TION DEBRIS AT ALL TIMES.
õ	
*	
2'-8"	
<u> </u>	
Not determine your	
	SITE PLAN APPROVED Planning Board, Town of Newburgh
	Orenge County New York
	Chairman El aglaga
	CALL BEFORE YOU DIG
	DIG SAFELY NEW YORK MUST BE CONTACTED (DIAL 811 OR 1-800-962-7962) AT LEAST TWO FULL WORKING DAYS PRIOR TO ANY EXCAVATION, DRILLING OR BLASTING TO HAVE ANY EXISTING UNDERGROUND UTILITIES
	LOCATED AND MARKED. NON-MEMBER UTILITIES MUST BE CONTACTED SEPARATELY.
. •	
•	SHEET 3 OF 3 IS INVALID UNLESS ACCOMPANIED BY SHEET 1 OF 3 AND SHEET 2 OF 3.
×.	
	AMENDED SITE PLAN - DETAIL SHEET
	CURALEAF NEWBURGH - BUILDING ADDITION
G A LICENSED OF THE NEW	8 NORTH PLANK ROAD, TOWN OF NEWBURGH
	ORANGE COUNTY, NEW YORK
	DATE: NOVEMBER 18, 2021 SCALE: AS SHOWN
	PREPARED BY:
	VINCENT J. DOCE ASSOCIATES
D GENERAL NOTES 1-7	- SURVEYORS - ENGINEERS - PLANNERS
- Nev. J. f. Miles,	41 MEAD ALLEY, MONTGOMERY, NY 12549 TEL. 845 561-1170 EMAIL DDOCE12@HOTMAIL.COM
ARKING DETAIL	TEL. 845 561-1170 EMAIL DDOCE12@HOTMAIL.COM
	AUDET A OF A AND
	SHEET 3 OF 3 Namen XIO

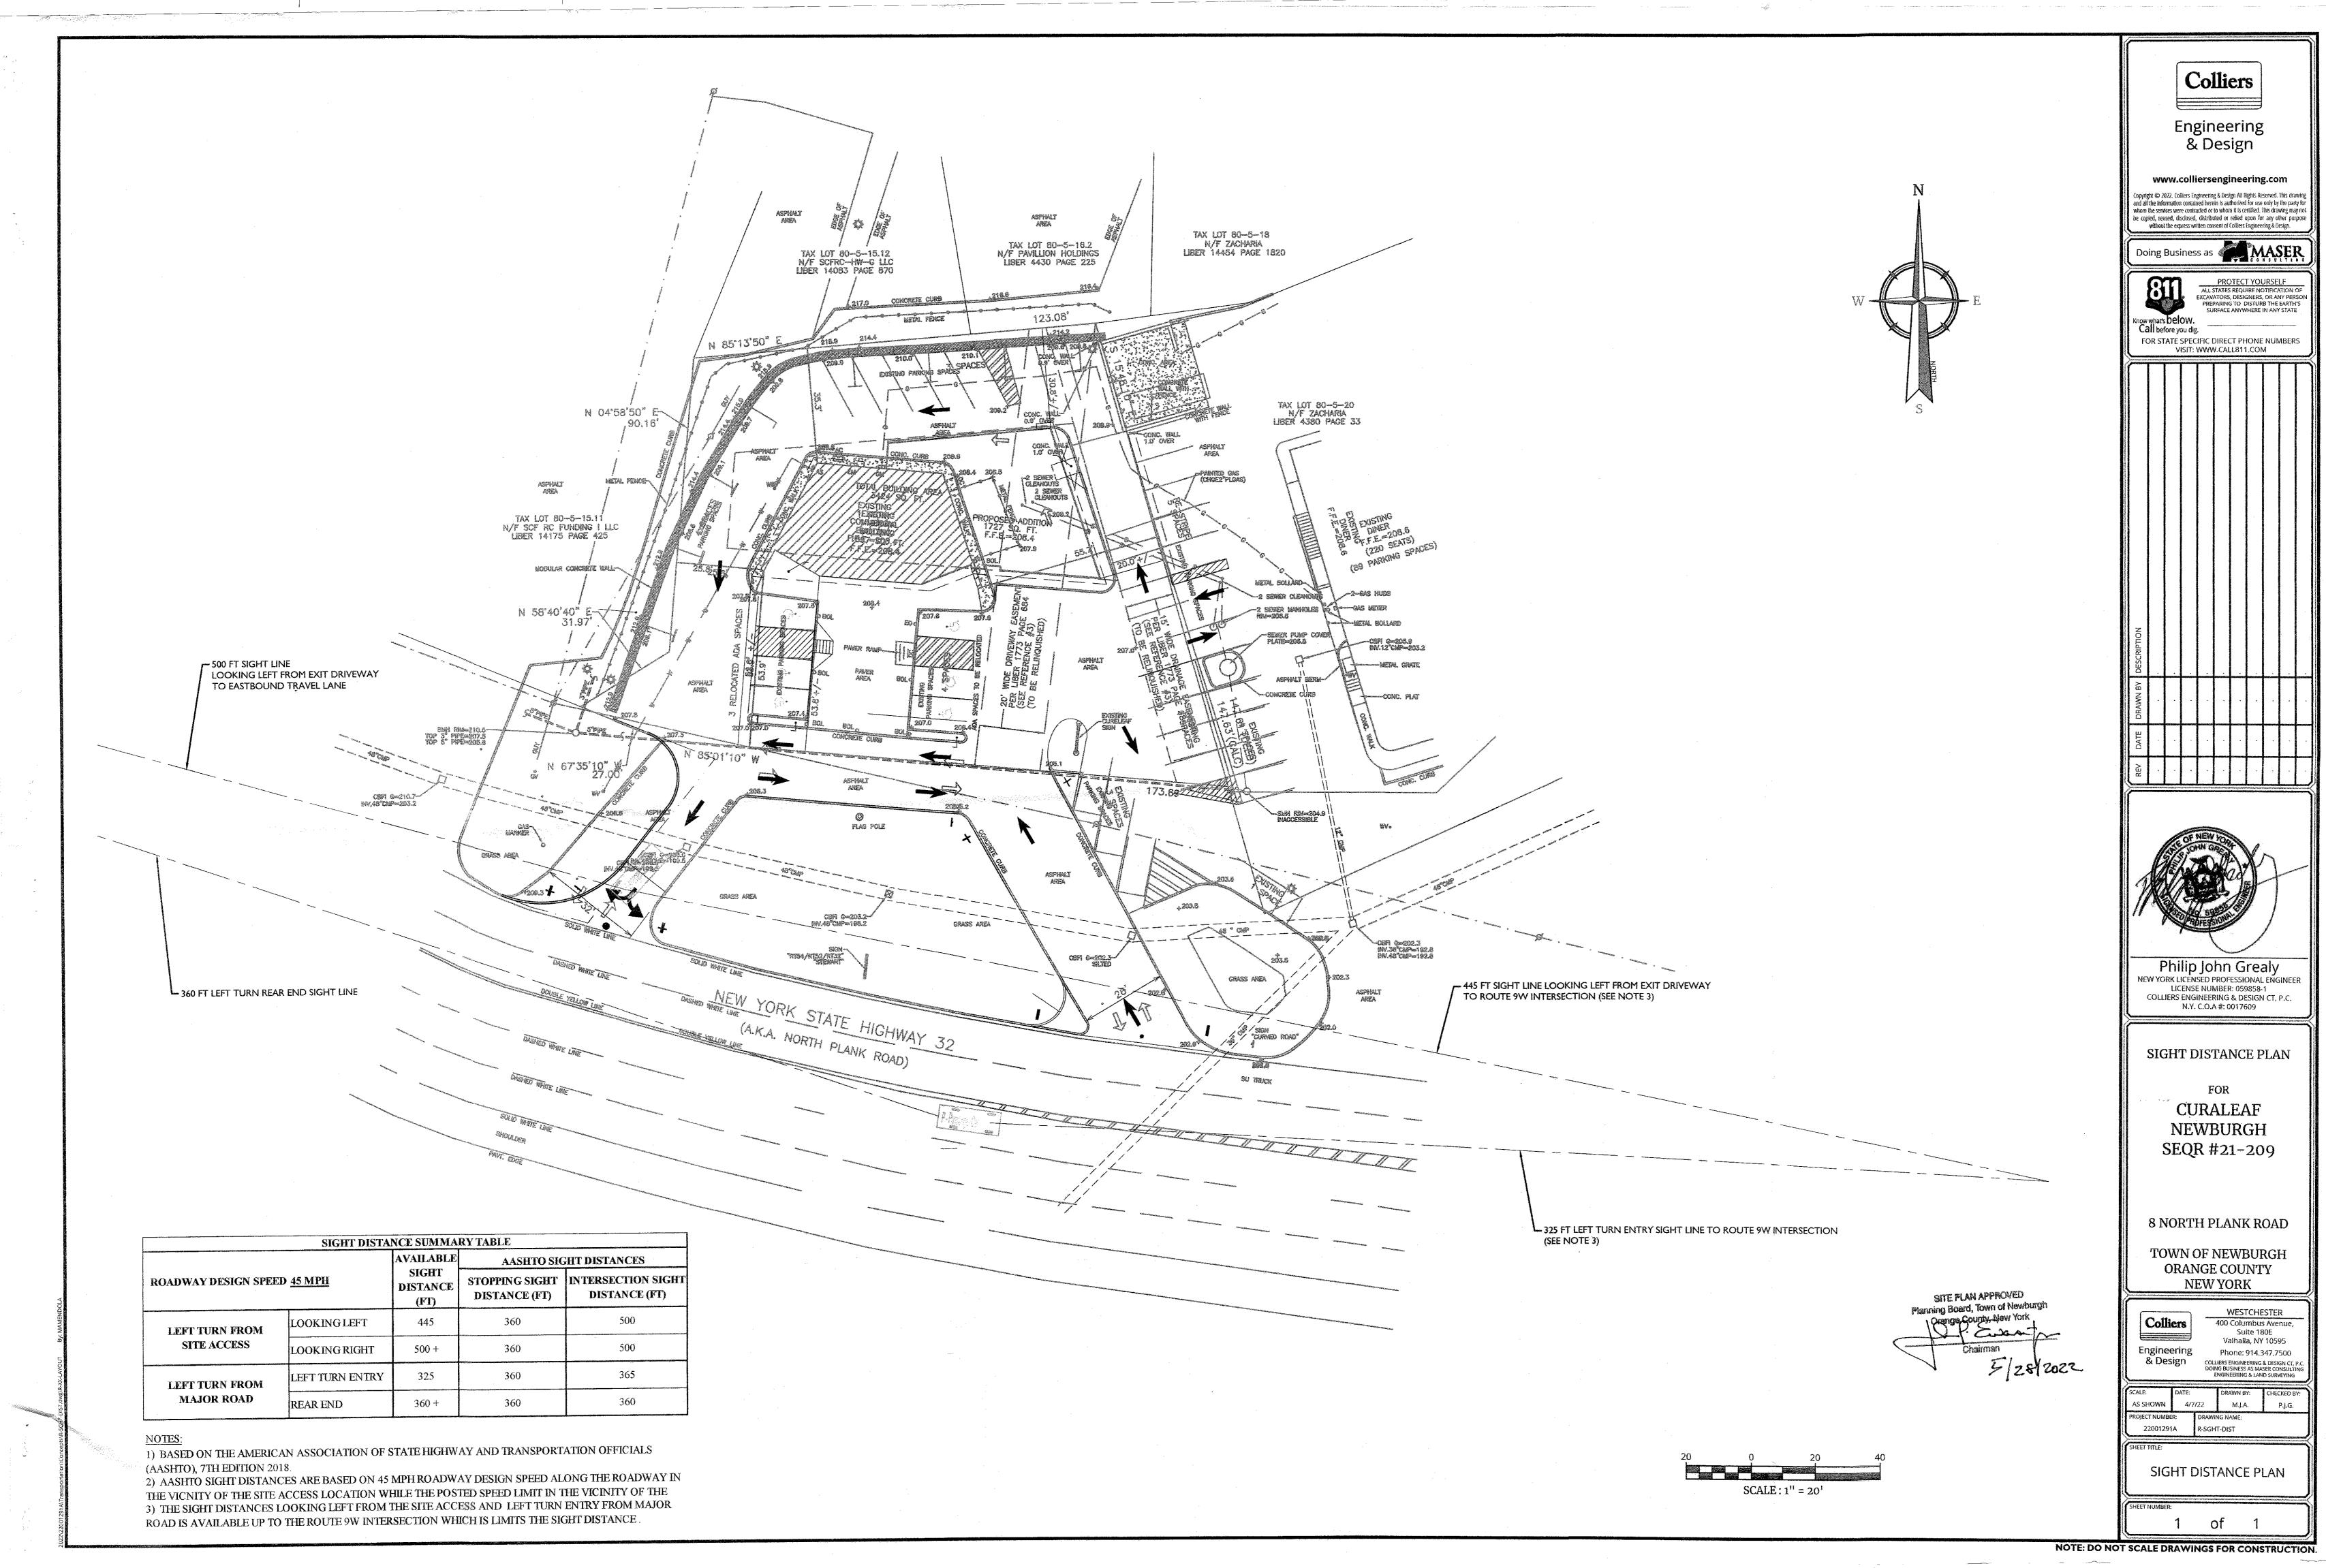

SIGHT DISTANCE SUMMARY TABLE					
ROADWAY DESIGN SPEED <u>45 MPH</u>		AVAILABLE	AASHTO SIGHT DISTANCES		
		SIGHT DISTANCE (FT)	STOPPING SIGHT DISTANCE (FT)	INTERSECTION SIGHT DISTANCE (FT)	
LEFT TURN FROM	LOOKING LEFT	445	360	500	
SITE ACCESS	LOOKING RIGHT	500 +	360	500	
LEFT TURN FROM MAJOR ROAD	LEFT TURN ENTRY	325	360	365	
	REAR END	360 +	360	360	